


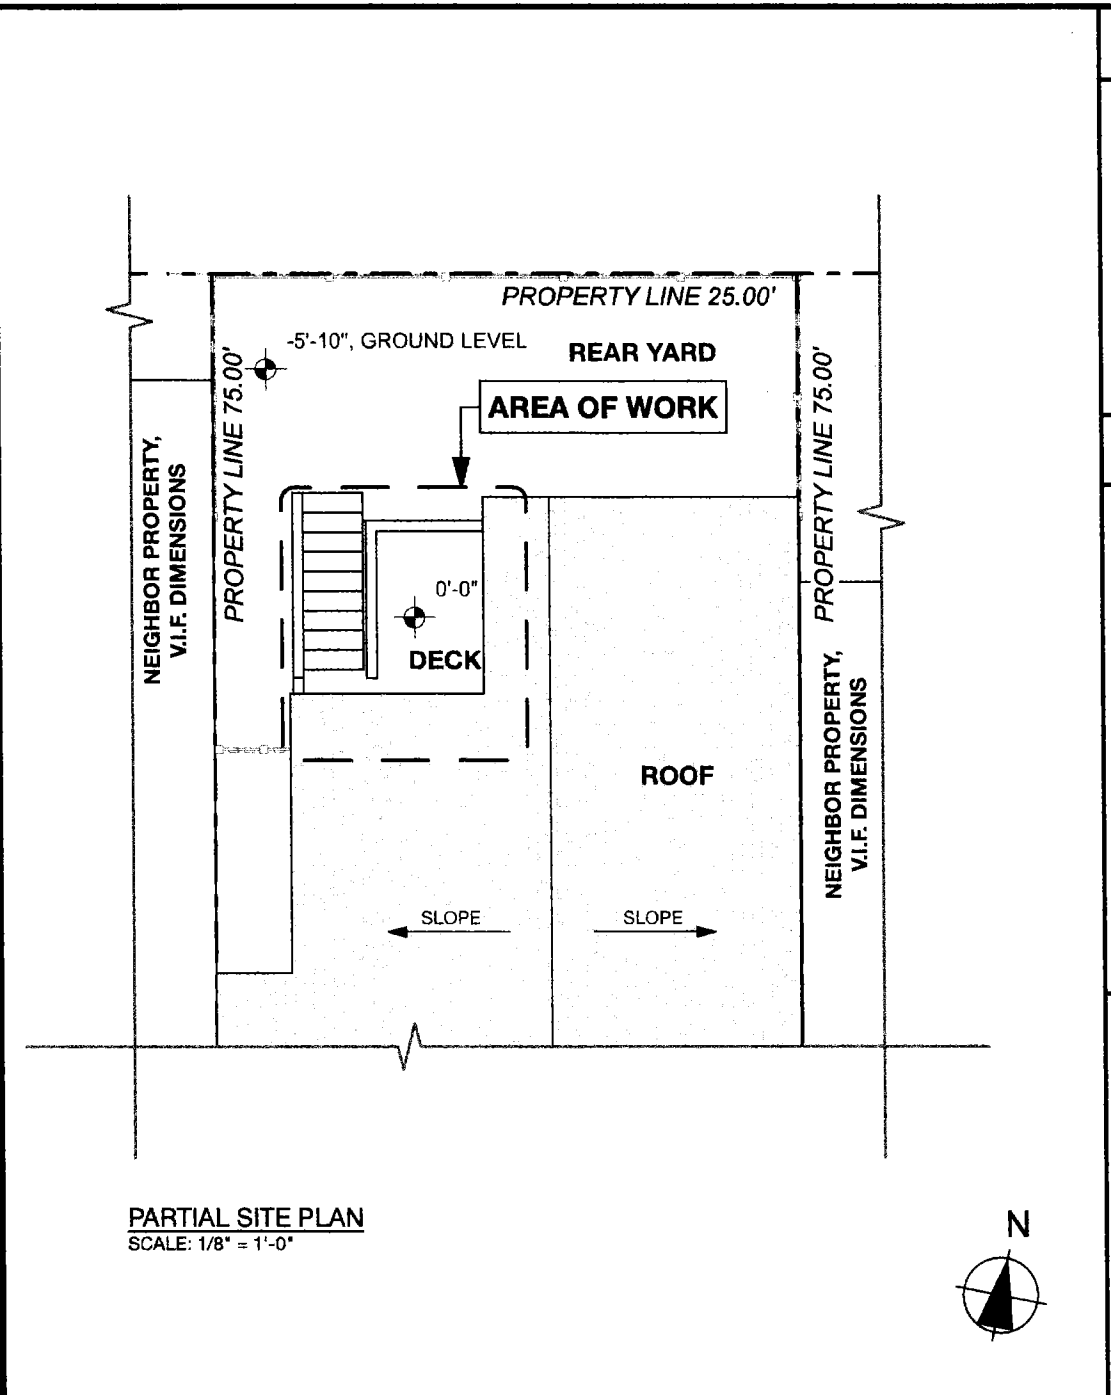


ABBREVIATIONS & SYMBOLS			
CAB.	CABINET	REF.	REFRIGERATOR
CL.	CLOSET	R	RISER
CLG.	CEILING	S.G.	STAIN GRADE
CL	CENTER LINE	SQFT.	SQUARE FOOT
DEM.	DEMOLISH	SSD.	SEE STRUCTURAL DRAWINGS
DN.	DOWN	TEL.	TELEPHONE LINE
(E)	EXISTING	T.O.	TOP OF
EXT.	EXTERIOR	TV	TELEVISION
FLR.	FLOOR	TYP.	TYPICAL
HT.	HEIGHT	U.O.N.	UNLESS OTHERWISE NOTED
INT.	INTERIOR	V.I.F.	VERIFY IN FIELD
INOP.	INOPERABLE	W/	WITH
L.O.	LINE OF	WD.	WOOD
MECH.	MECHANICAL		
MIN.	MINIMUM		
(N)	NEW		
N.T.S.	NOT TO SCALE		
O/	OVER		
O.C.	ON CENTER		
P.G.	PAINT GRADE		

	ALIGN
	HIDDEN LINE
	EXISTING STUD WALL (UNLESS NOTED OTHERWISE)
	NEW STUD WALL (UNLESS NOTED OTHERWISE)
	ELEVATION POINT
	DOOR MARKER
	WINDOW MARKER
	REVISION
	DRAWING/DETAIL REFERENCE NUMBER
	DRAWING OR DETAIL SHEET WHERE DRAWING/DETAIL OCCURS
	ELEVATION REFERENCE NUMBER
	BUILDING ELEVATION SHEET WHERE ELEVATION OCCURS

PROJECT DATA	
PARCEL NUMBER:	2649/019
LOT SIZE:	1875 SQFT.
BUILDING AREA:	1300 SQFT.
YEAR BUILT:	1906
NO. OF STORIES:	1
OCCUPANCY CODE:	RH-3
BUILDING USE:	1 FAMILY DWELLING
CONSTRUCTION CLASSIFICATION:	TYPE VB

CODES	CONTACT
2013 CA BLDG. CODE 2013 S.F. BLDG. CODE & AMENDMENTS 2013 CA ENERGY CODE 2013 S.F. ELECTRICAL CODE 2013 S.F. MECHANICAL CODE 2013 S.F. PLUMBING CODE 2013 S.F. FIRE CODE	OWNER DAVID JEROME 4328 18th Street, San Francisco, CA 94114 Ph.: 415-596-7401 davidjerome53@gmail.com Owner since 5/14/08 PREPARER: SARAH REEVES, SAZEN DESIGN LLC 298 Stantonville drive, Oakland, CA 94619 Ph.: 617-620-1466 sarahreeves56@gmail.com

NOTE: ALL WORK EXISTING AND PROPOSED SHALL BE IN COMPLIANCE WITH ALL APPLICABLE LOCAL BUILDING CODES AND REGULATIONS.

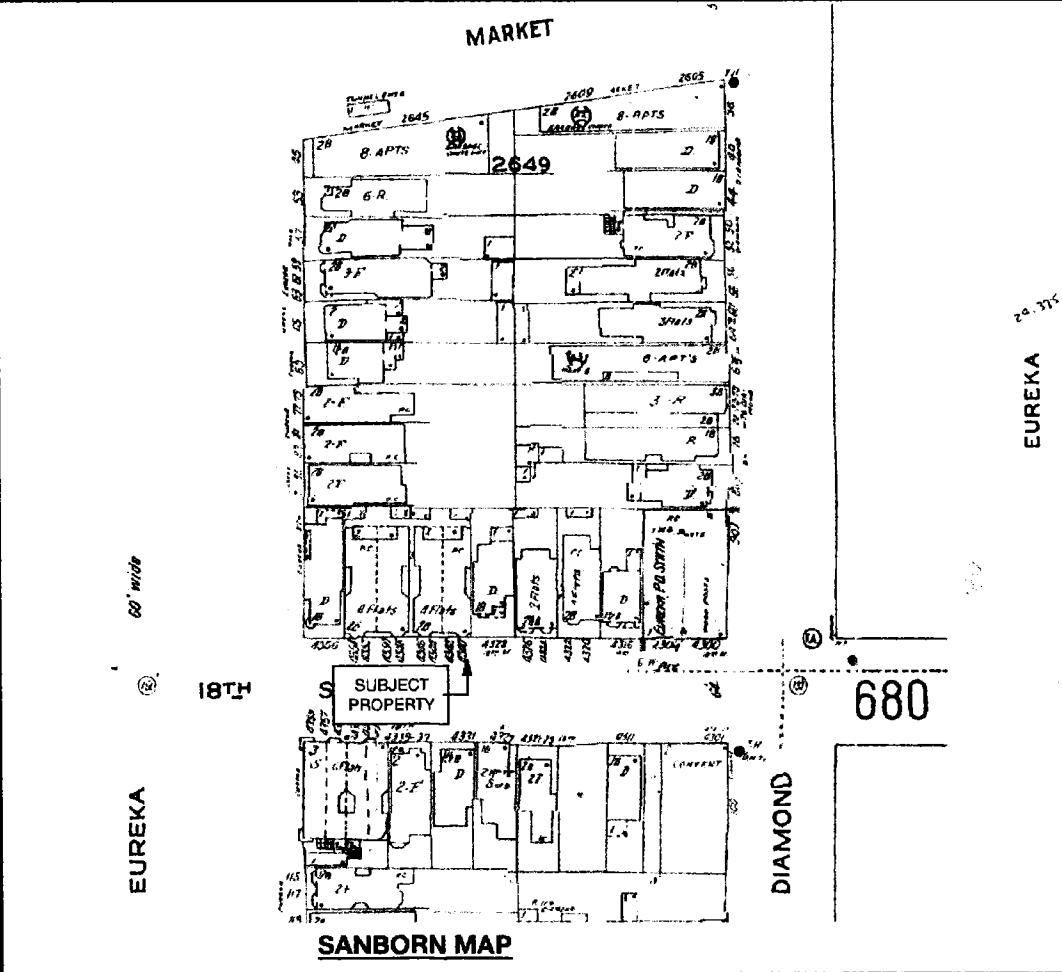

VICINITY MAP

SCOPE OF WORK:

SUBMISSION FOR PERMIT OF SMALL DECK & STAIR AT REAR YARD AREA
PER NOTICE # 200560421

SHEET INDEX

ARCHITECTURAL:

- A 0.0 TITLE SHEET
- A 0.1 EXISTING SITE PHOTOS
- A 1.1 DECK PLAN & ELEVATION (AS-BUILT)

PROJECT STAGE:
PERMIT SET


DATE: 11/12/14

DRAWN BY:
SARAH REEVES, PRINCIPAL,
SAZEN DESIGN


SCALE: NOT TO SCALE

Title Sheet

A 0.0

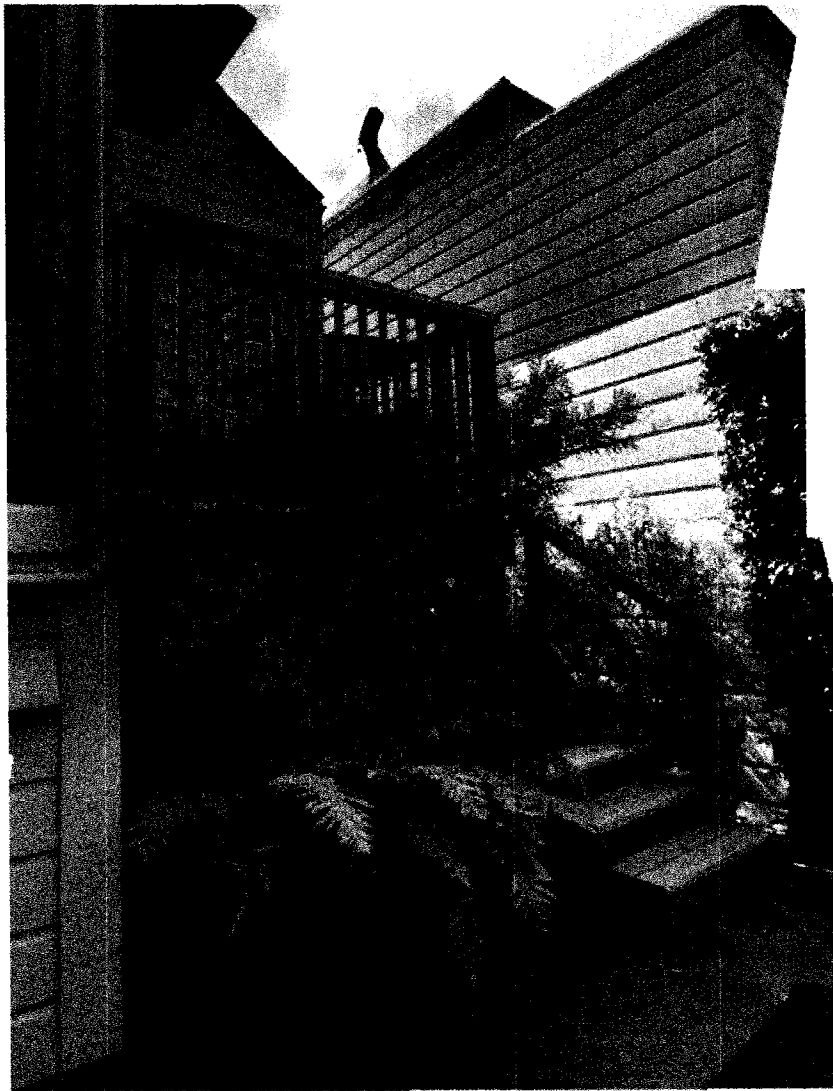

DECK VIEW FROM REAR YARD

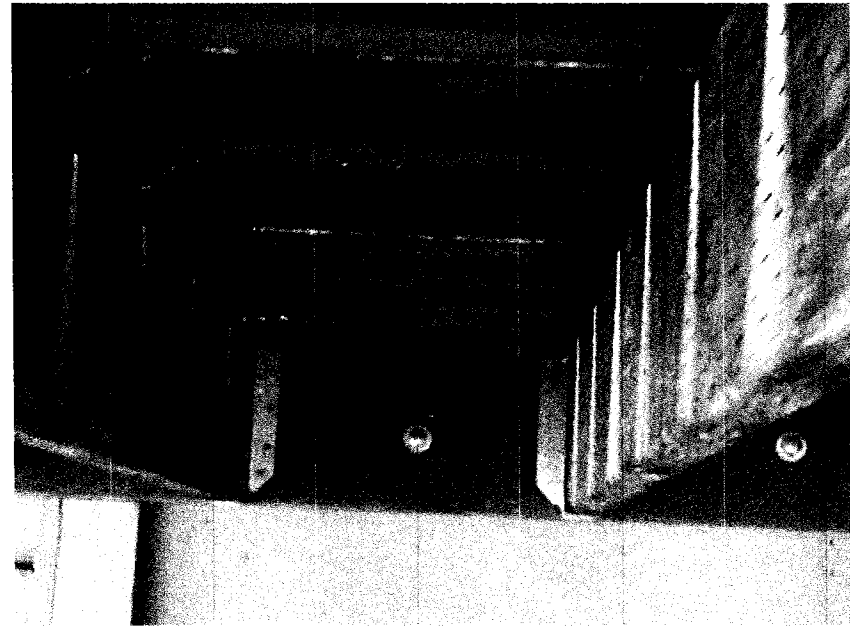


DECK LEDGER @ BUILDING EXTERIOR WALL



DECK VIEW 1



DECK VIEW 2

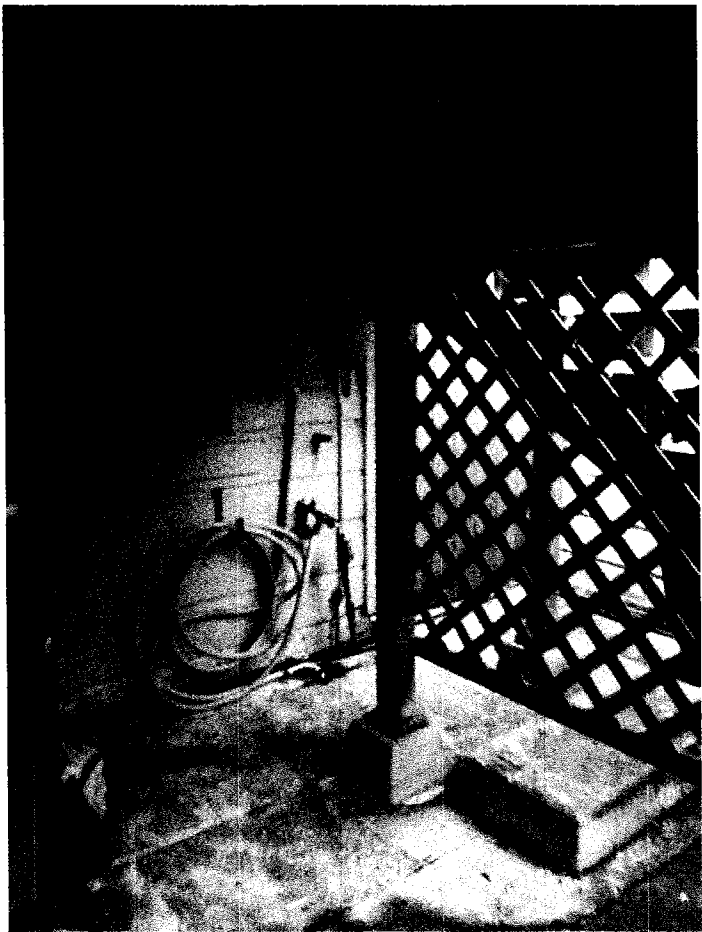

UNDER DECK, POSTS, FOOTINGS



STAIR VIEW FROM PATIO

Handwritten signature

4328 18TH STREET
SAN FRANCISCO, CA 94114


PROJECT STAGE:
PERMIT SET
DATE: 11/12/14

DRAWN BY:
SARAH REEVES, PRINCIPAL,
SAZEN DESIGN


SCALE: NOT TO SCALE

Existing Site
Photos

A 0.1

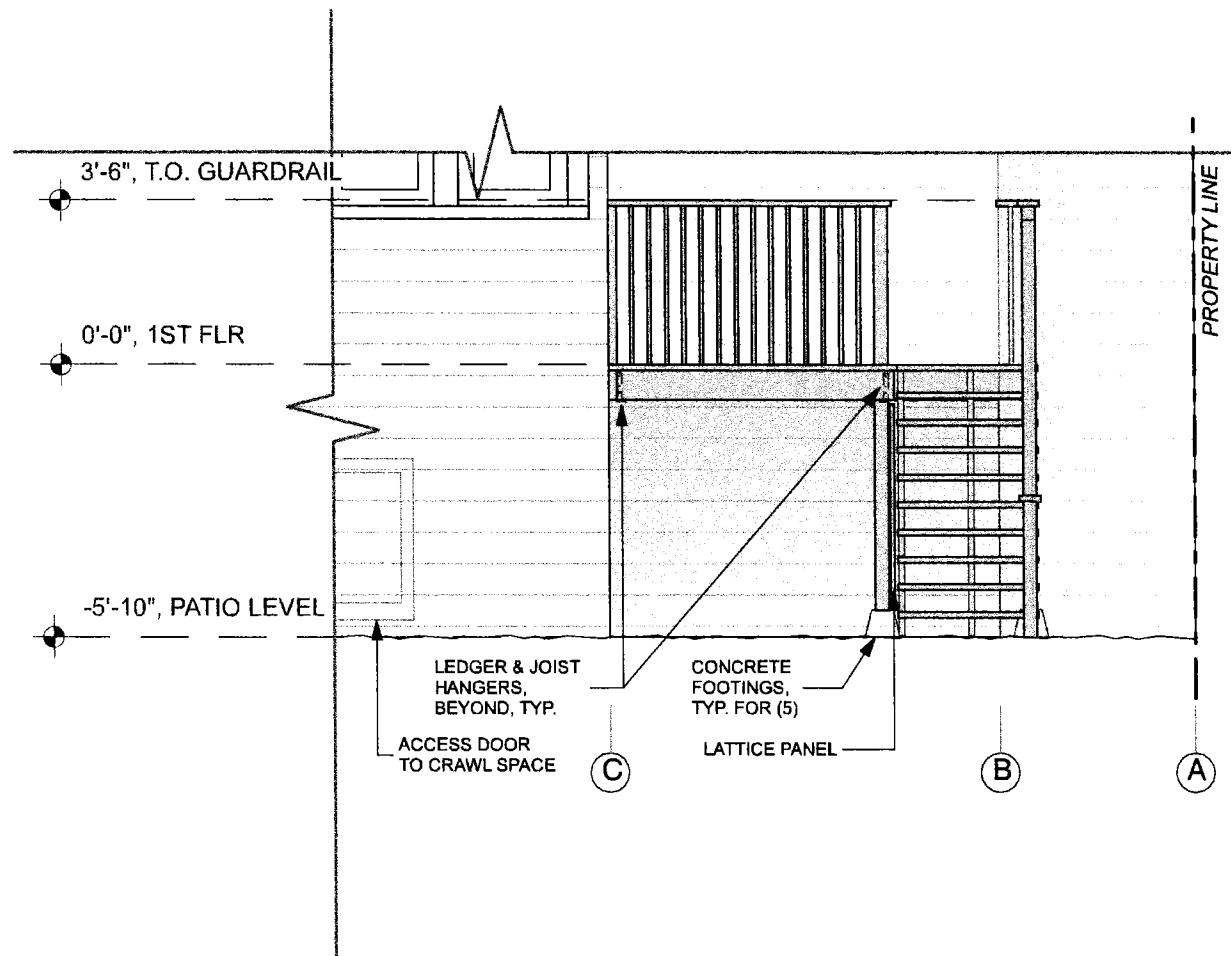

2 DECK ELEVATION

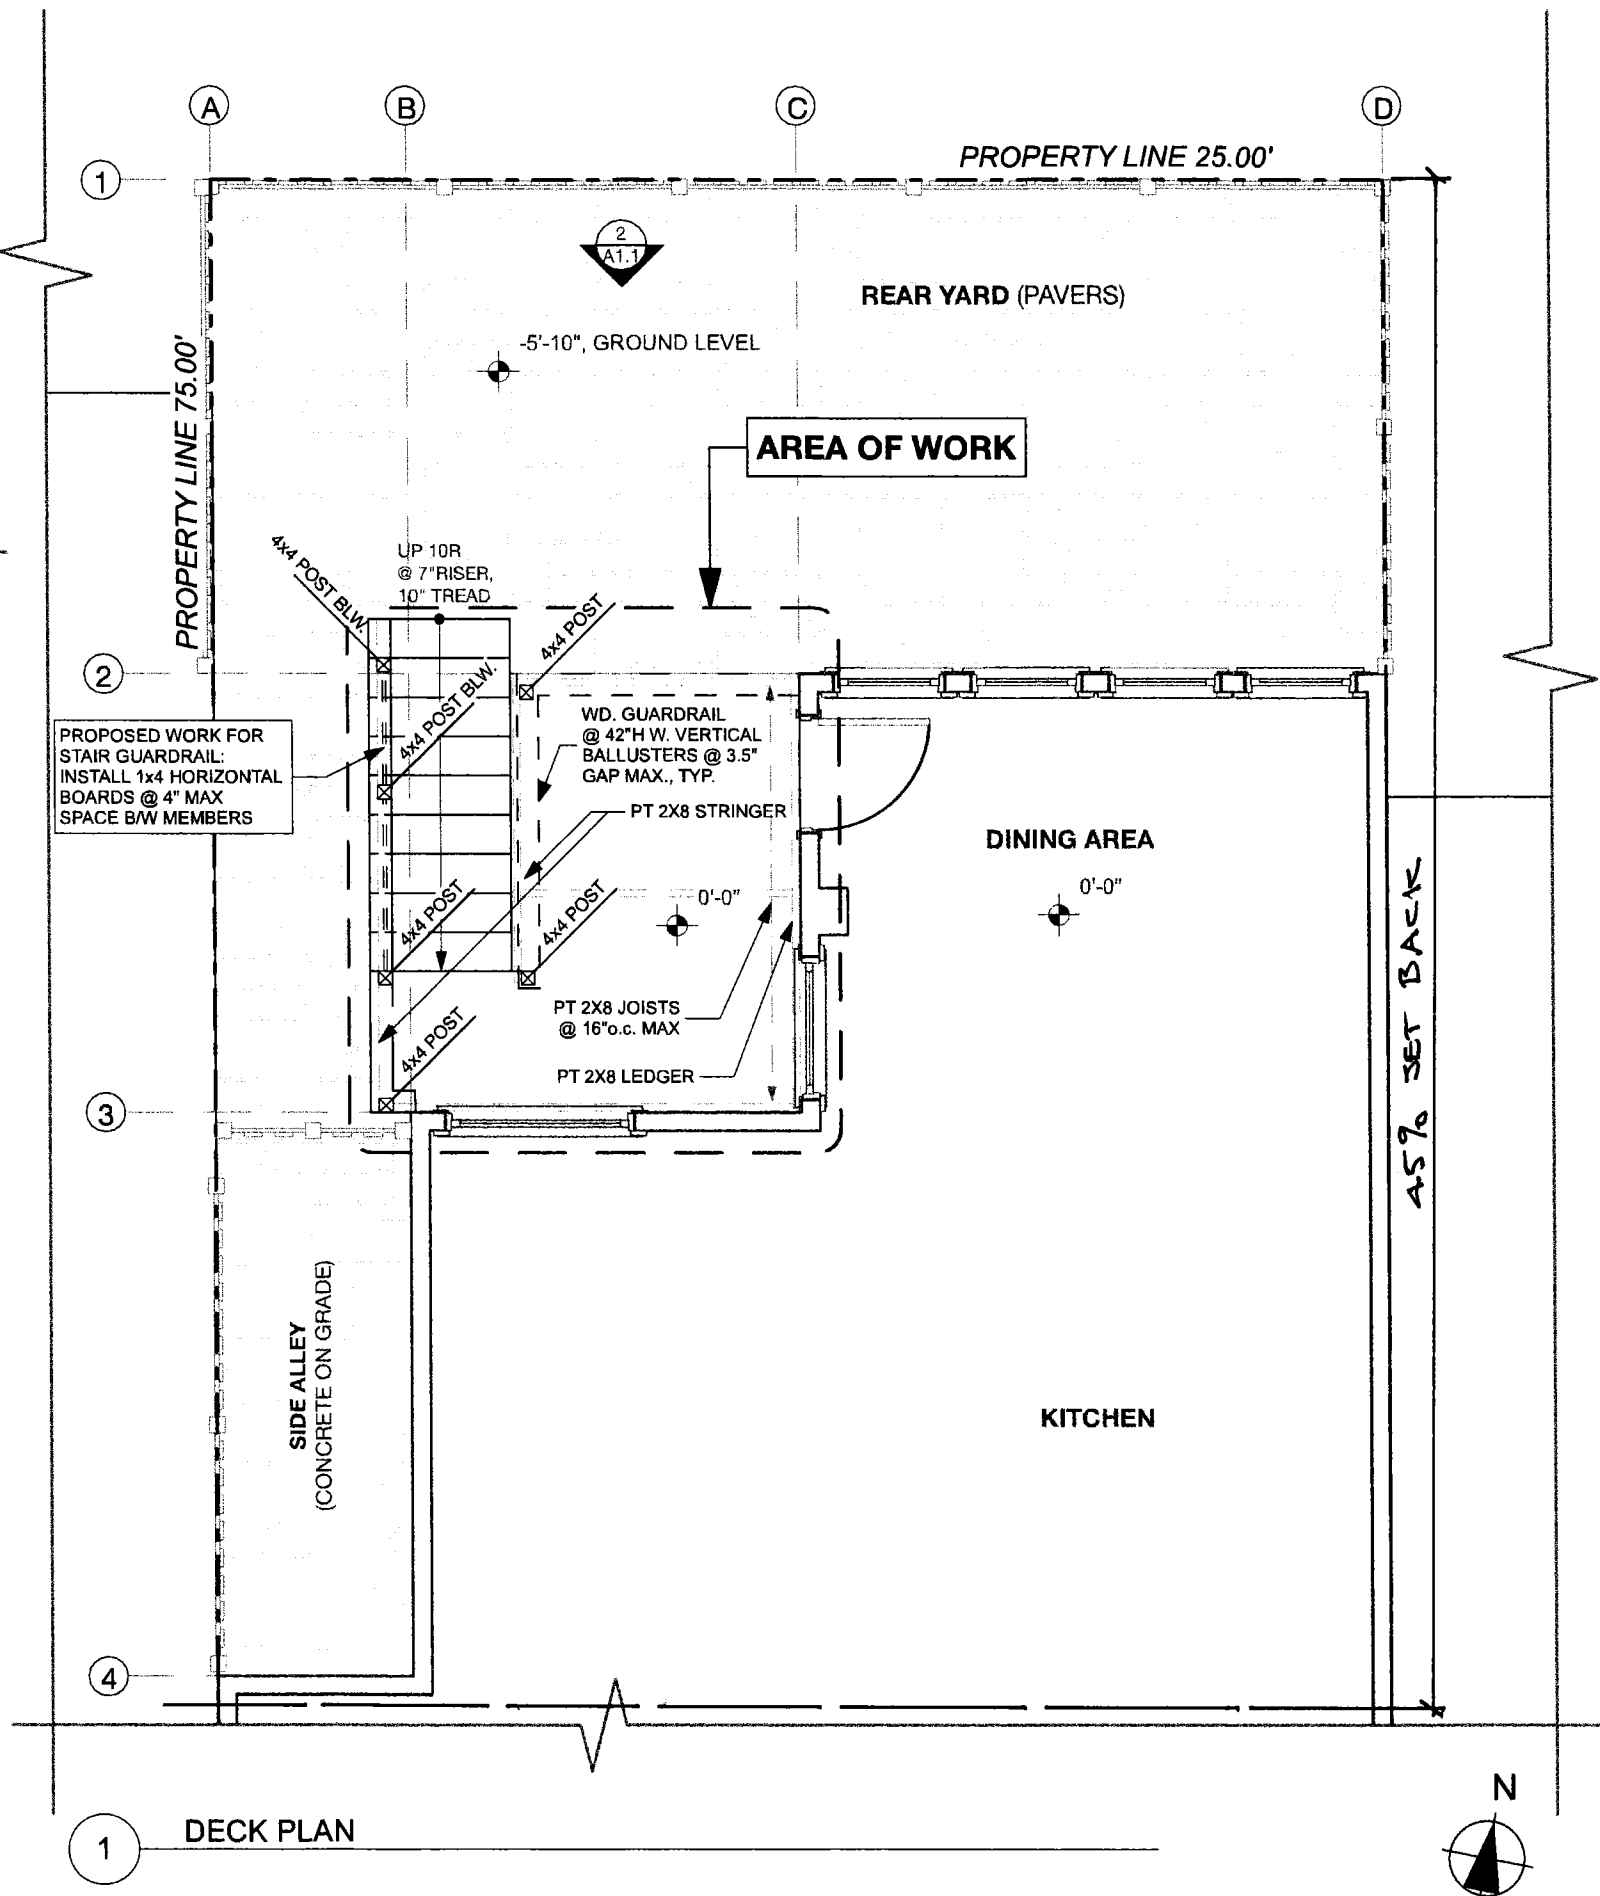

1 DECK PLAN

4328 18TH STREET
SAN FRANCISCO, CA 94114

PROJECT STAGE:
PERMIT SET
DATE: 11/12/14

DRAWN BY:
SARAH REEVES, PRINCIPAL,
SAZEN DESIGN

SCALE: 1/4" = 1'-0"

Deck Plan &
Elevation

A 1.1