



# SAN FRANCISCO PLANNING DEPARTMENT

**MEMO**

## Disclaimer for Review of Plans

The San Francisco Planning Code requires that the plans of certain proposed projects be provided to members of the public prior to the City's approval action on the project. Accordingly, any images of plans featured on this website are provided for the primary purpose of facilitating public input prior to the City's action. The City and County of San Francisco does not own the copyright to these images. Please be aware that the unauthorized reproduction, distribution, or alteration of these images may result in a violation of Federal Copyright Law (17 U.S.C.A. Sections 101 et seq.) and that any party who seeks to reproduce or alter these images does so at his or her own risk.

Additionally, plans provided on this website are limited to site plans, elevations and/or section details (floor plans and structural details may not be included). These are DRAFT PLANS being provided for public review PRIOR to the City's approval action on the project. Final plans may differ from those that are currently available for review.

1650 Mission St.  
Suite 400  
San Francisco,  
CA 94103-2479

Reception:  
**415.558.6378**

Fax:  
**415.558.6409**

Planning  
Information:  
**415.558.6377**



# SAN FRANCISCO PLANNING DEPARTMENT

1650 Mission Street, Suite 400 • San Francisco, CA 94103 • Fax (415) 558-6409

## NOTICE OF PUBLIC HEARING

Hearing Date: **Wednesday, February 22, 2017**  
Time: **Not before 9:30 AM**  
Location: **City Hall, 1 Dr. Carlton B. Goodlett Place, Room 408**  
Case Type: **Variance (Rear Yard)**  
Hearing Body: **Zoning Administrator**

PROPERTY INFORMATION		APPLICATION INFORMATION	
Project Address:	<b>1649 Washington Street</b>	Case No.:	<b>2015-003259VAR</b>
Cross Street(s):	<b>Polk St. / Larkin St.</b>	Building Permit:	<b>2015.03.06.0160</b>
Block /Lot No.:	<b>0620 / 024</b>	Applicant:	<b>Roy Grant</b>
Zoning District(s):	<b>RM-2 / 65-A</b>	Telephone:	<b>(650) 465-2275</b>
Area Plan:	<b>N/A</b>	E-Mail:	<b><a href="mailto:1649washington@gmail.com">1649washington@gmail.com</a></b>

### PROJECT DESCRIPTION

The proposal seeks to legalize a 3-story deck structure that was built without permit.

**PER PLANNING CODE SECTION 134**, the subject property is required to maintain a rear yard of approximately 49 feet. A 1-story popout structure with deck above was constructed with permit, and then subsequently an additional 3-story deck (two additional floor levels of decking) was constructed without permit above the popout, and does not conform to the listed permitted obstructions in Section 136. This project seeks to legalize this deck structure; therefore a variance is required.

### ADDITIONAL INFORMATION

**ARCHITECTURAL PLANS:** The site plan and elevations of the proposed project are available on the Planning Department's website at: <http://notice.sfplanning.org/2015-003259VAR.pdf>

Members of the public are not required to provide personal identifying information when they communicate with the Commission or the Department. All written or oral communications, including submitted personal contact information, may be made available to the public for inspection and copying upon request and may appear on the Department's website or in other public documents.

**FOR MORE INFORMATION, PLEASE CONTACT PLANNING DEPARTMENT STAFF:**

Planner: **Andrew Perry** Telephone: **(415) 575-9017** E-Mail: **[andrew.perry@sfgov.org](mailto:andrew.perry@sfgov.org)**

# GENERAL INFORMATION ABOUT PROCEDURES

## HEARING INFORMATION

You are receiving this notice because you are either a property owner or resident that is adjacent to the proposed project or are an interested party on record with the Planning Department. **You are not required to take any action. For more information regarding the proposed work, or to express concerns about the project, please contact the Applicant or Planner listed on this notice as soon as possible.** Additionally, you may wish to discuss the project with your neighbors and/or neighborhood association, as they may already be aware of the project.

Persons who are unable to attend the public hearing may submit written comments regarding this application to the Planner listed on the front of this notice, Planning Department, 1650 Mission Street, Suite 400, San Francisco, CA 94103, by 5:00 pm the day before the hearing. These comments will be made a part of the official public record and will be brought to the attention of the person or persons conducting the public hearing.

Comments that cannot be delivered by 5:00 pm the day before the hearing may be taken directly to the hearing at the location listed on the front of this notice. Comments received at 1650 Mission Street after the deadline will be placed in the project file, but may not be brought to the attention of the Zoning Administrator at the public hearing.

## BUILDING PERMIT APPLICATION INFORMATION

Pursuant to Planning Code Section 311 or 312, the Building Permit Application for this proposal may also be subject to notification of property owners and residents within 150-feet of the subject property. **The mailing of such notification will be performed separately.**

## APPEAL INFORMATION

An appeal of the approval (or denial) of a **Variance application** by the Zoning Administrator may be made to the **Board of Appeals within 10 calendar days** after the Variance Decision Letter is issued by the Zoning Administrator.

An appeal of the approval (or denial) of a **building permit application** by the Planning Commission may be made to the **Board of Appeals within 15 calendar days** after the building permit is issued (or denied) by the Director of the Department of Building Inspection.

Appeals must be submitted in person at the Board's office at 1650 Mission Street, 3rd Floor, Room 304. For further information about appeals to the Board of Appeals, including current fees, contact the Board of Appeals at (415) 575-6880.



## MULTI-FAMILY

<b>CS1.0</b>	<b>COVER SHEET- PROJECT DATA</b>
<b>SP1.0</b>	<b>SITE PLAN &amp; PRE-APPLICATION LETTER</b>
<b>A1.0</b>	<b>DECK PLANS</b>
<b>S1.0</b>	<b>BUILDING ELEVATIONS</b>



Michael Wright

## LEGEND



## FOR LOCAL & STATE LAWS

## PROJECT DATA

PROPOSED PROJECT WHICH IS NO USE CHANGE. THERE ARE STRUCTURAL CHANGES OF WORK IN THE PROJECT SCOPE. FRAMED PER CONVENTIONAL FRAMING METHODS.

LEGALIZE EXISTING DECK IN REAR. PROVIDE 1-HR ASSEMBLY WITHIN 5' OF PROPERTY LINE.

BUILDING HT:	4'-10"
GROSS FLOOR AREA:	9,780 S.F.
HABITABLE SF:	9,280 S.F.
NONHABITAL SF-(GARAGE)	500 S.F.
STORIES./BASEMENT	3/1 S.F.
# OF UNITS:	7

CS1.0

**EXISTING REAR DECK  
1649-57 WASHINGTON ST.  
SAN FRANCISCO, CA**

# INFINITY DESIGNS

231 ISLON WAY, ELK GROVE, CA 95757 (707) 208-9217






**EXISTING REAR DECK**  
**1649-57 WASHINGTON ST.**  
**SAN FRANCISCO, CA**

**SHEET      OF**

**SCALE: NTS**

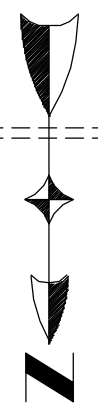




**EXISTING REAR DECK  
1649-57 WASHINGTON ST.  
SAN FRANCISCO, CA**




**INFINITY DESIGNS**  
55331 JISLON WAY, ELK GROVE, CA 95757 (707) 208-9217

**EXISTING REAR DECK  
1649-57 WASHINGTON ST.  
SAN FRANCISCO, CA**

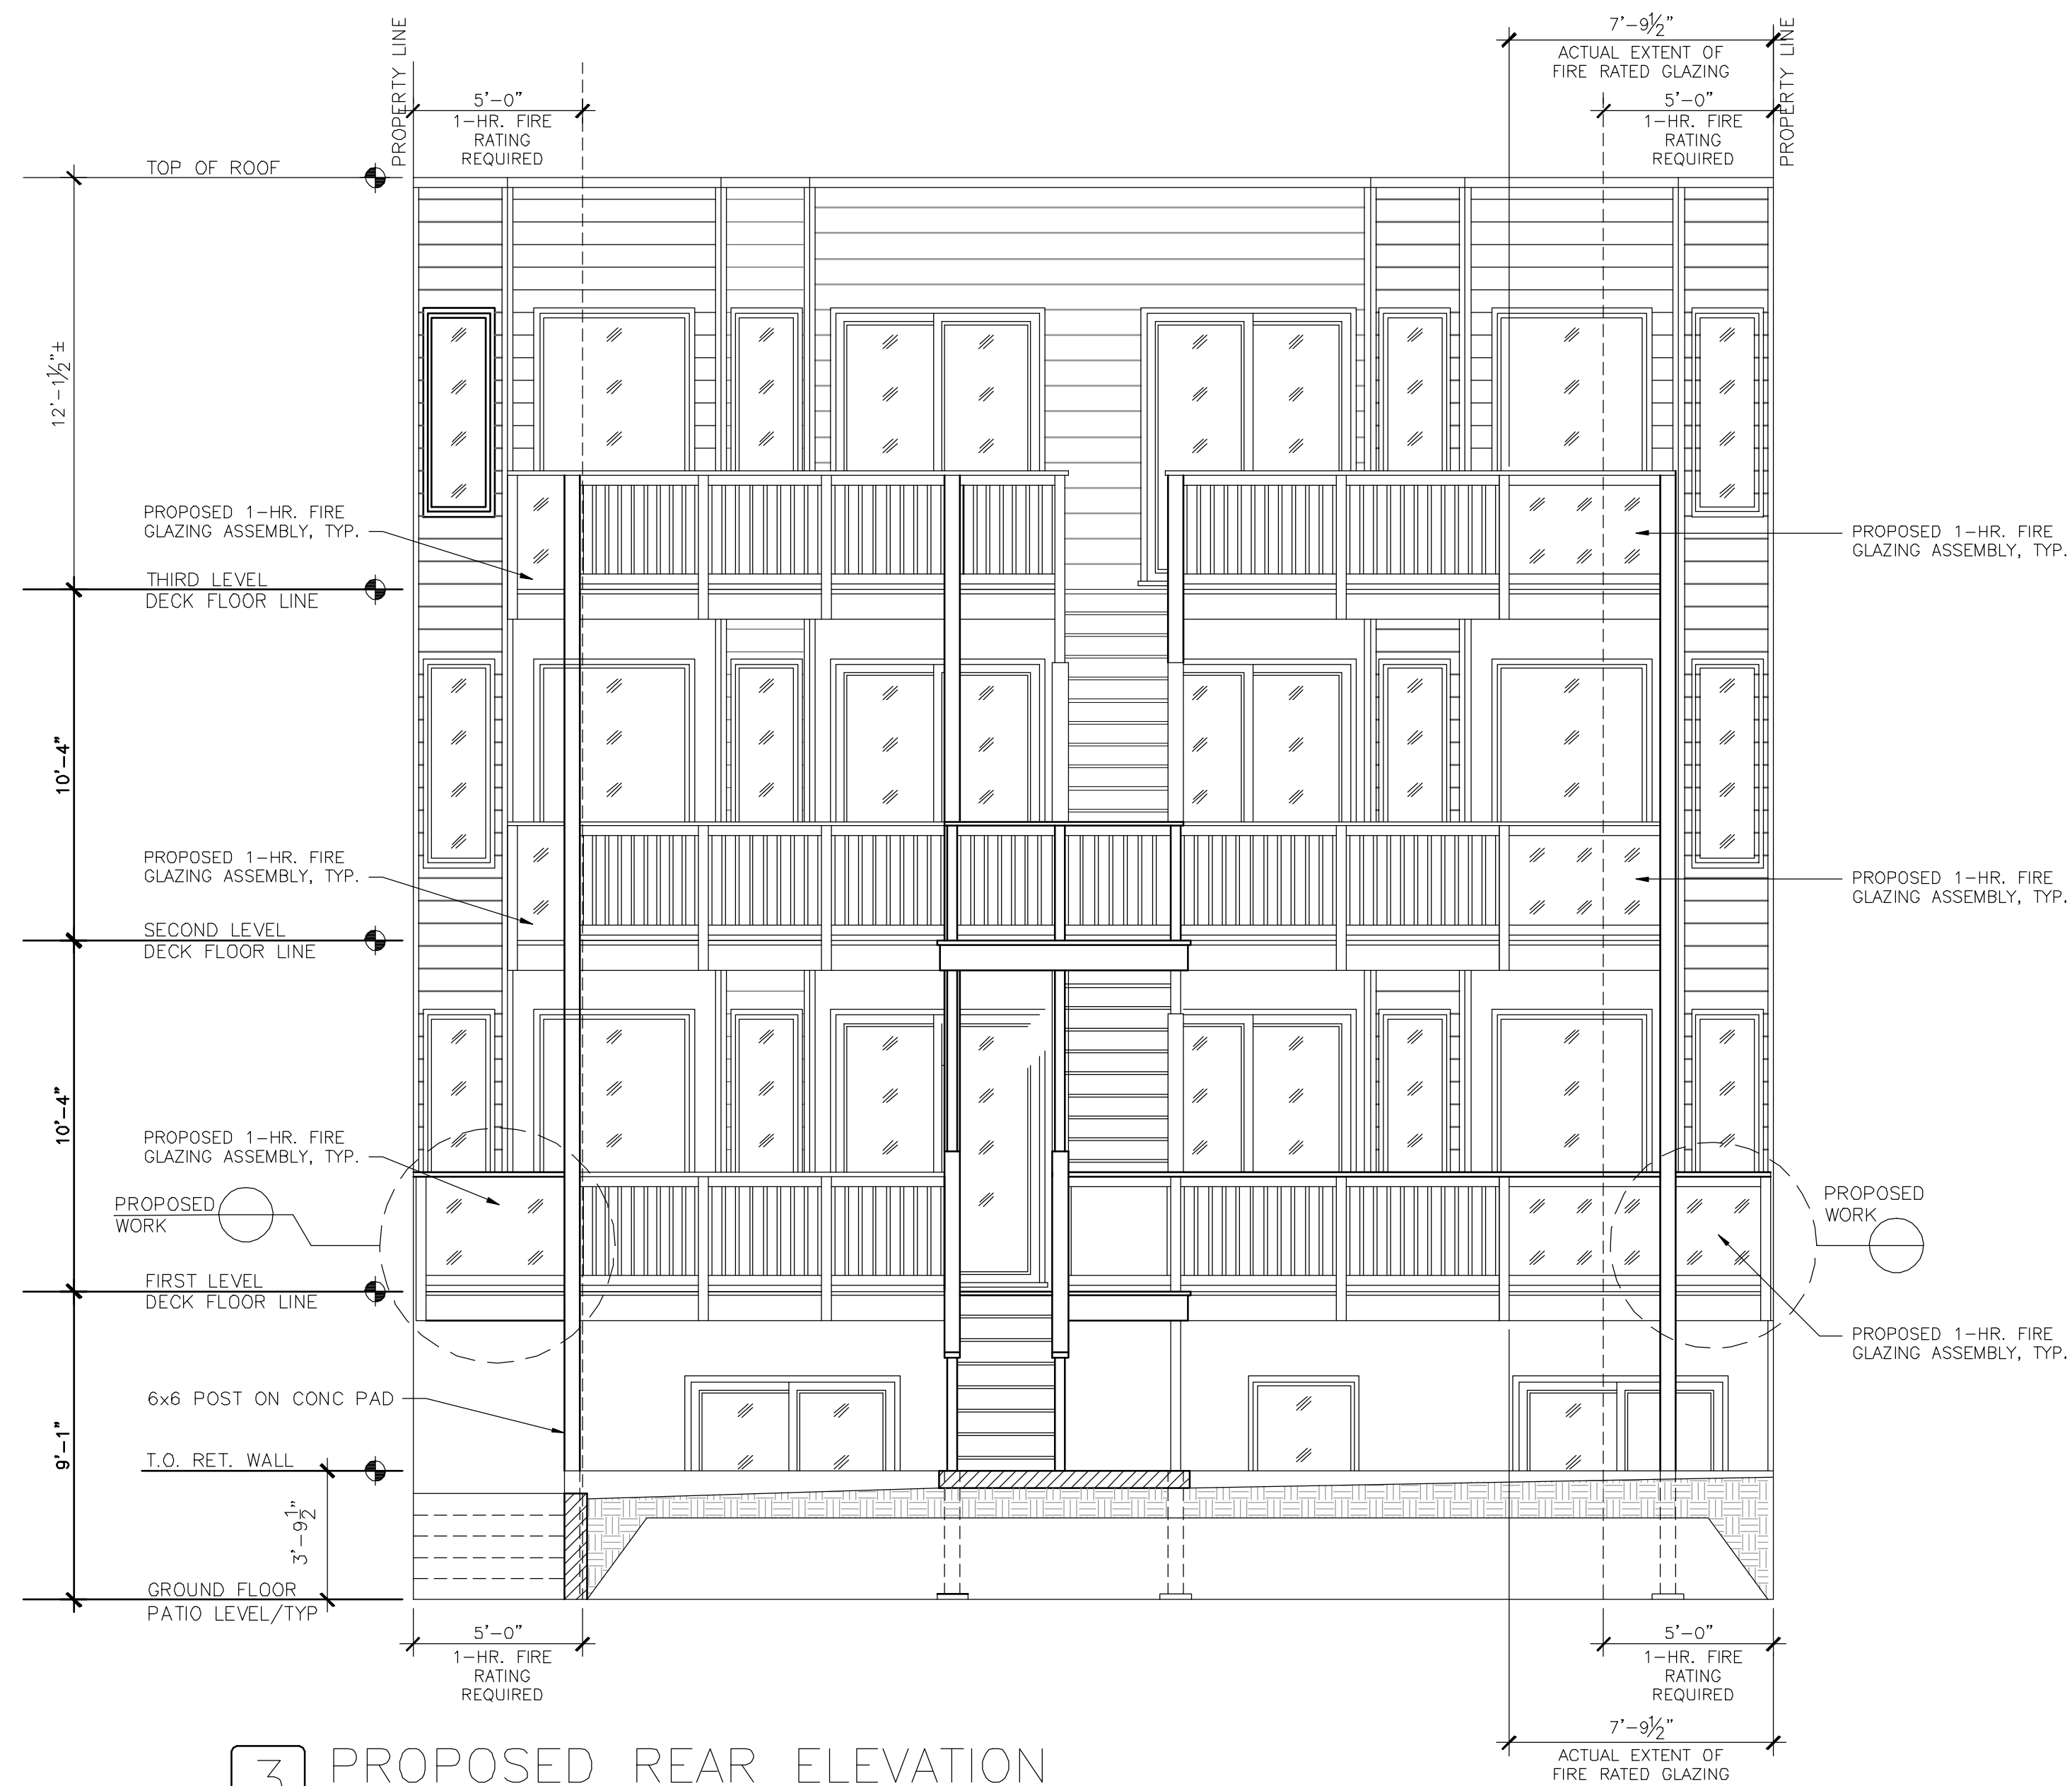

3 PROPOSED REAR ELEVATION  
SCALE: 1/4"=1'-0"

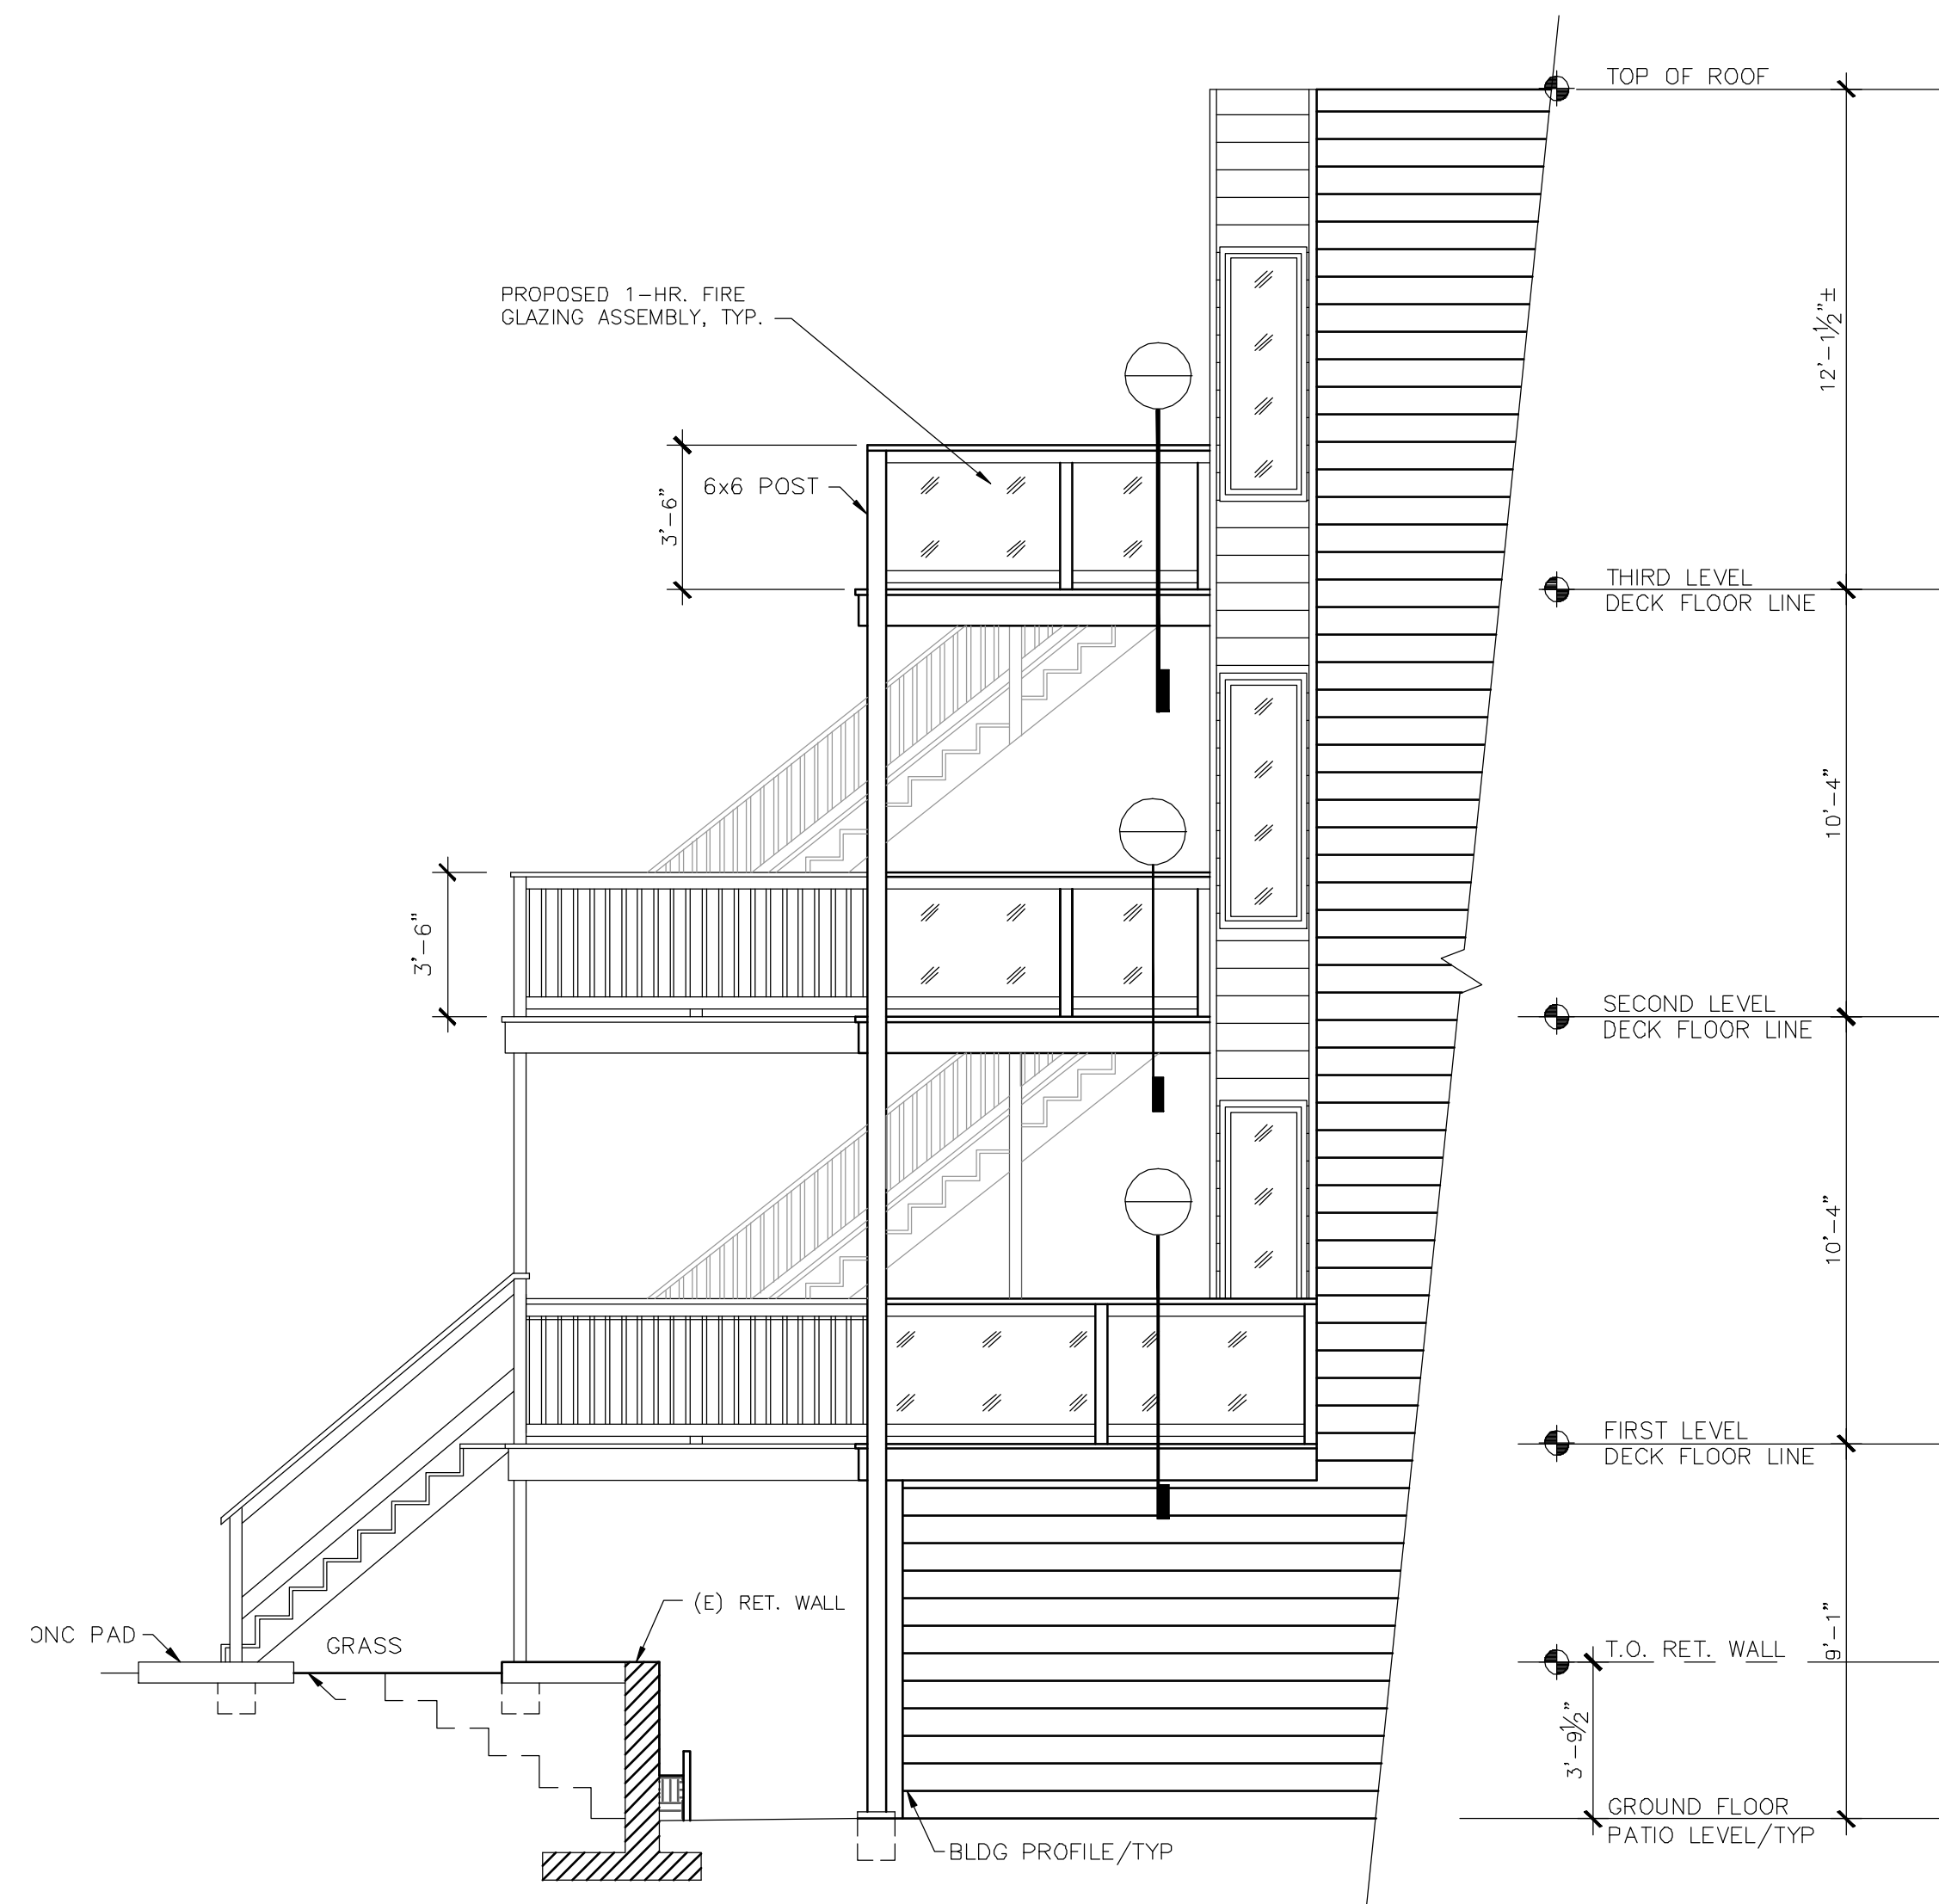

4 PROPOSED SIDE ELEVATION  
SCALE: 1/4"=1'-0"

[illegible]